

PROJECT DESCRIPTION:

A QL-B OVERHEAD/SUBSURFACE UTILITY ENGINEERING INVESTIGATION (SUE) WAS PERFORMED AND COMPLETED BY TBE GROUP, INC. ON 11/23/10 FOR THIS PROJECT. THE EXISTING OVERHEAD AND UNDERGROUND FACILITIES SHOWN HEREON WERE INCLUDED IN THIS SUE INVESTIGATION. THE PRESENCE OF THESE UTILITIES HAVE BEEN THOROUGHLY INVESTIGATED AND THE METHOD OF DETERMINING THEIR LOCATION IS INDICATED AS SHOWN IN THE PLANS. UTILITIES THAT HAVE BEEN INSTALLED AFTER THE DATE ABOVE HAVE NOT BEEN INCLUDED IN THIS INVESTIGATION AND SHOULD BE CONSIDERED AS FROM RECORD DRAWING ONLY. ALL OTHER EXISTING TOPOGRAPHIC FEATURES DEPICTED HEREON HAVE BEEN REFERENCED FROM TOPOGRAPHIC/MAPPING PROVIDED BY PARSONS AND SURVEY PACKAGE PROVIDED BY ARCADIS WITH A DATE OF 10/27/09.

GENERAL NOTES:

- 1. SIZES AND MATERIAL TYPES ARE FROM FIELD VERIFICATION. WHEN NOT ATTAINABLE, THEY ARE NOTED PER RECORD PLANS.
- 2. PRIVATE LIGHT POLES MAY NOT SHOW CONNECTIVITY.
- 3. SOME SERVICES STOP SHORT OF THE LOS DUE TO PRIVATE PROPERTY.
- 4. PREVIOUSLY OWNED SEPSCO FACILITIES NOW OWNED BY GEORGIA POWER.

UTILITY SUMMARY:

ALL OF THE FOLLOWING UTILITY OWNERS WERE REPORTED THE HAVE FACILITIES WITHIN THE VICINITY OF THIS PROJECT AT THE TIME OF THE SUE INVESTIGATION. UTILITIES FOUND WITHIN THE LOS AT THE TIME OF THE INVESTIGATION ARE NOTED FOR EACH OWNER LISTED AND ARE SHOWN ON THE PLANS HEREON.

(ROF) = RECORDS ON FILE (RNA) = RECORDS NOT AVAILABLE

1. AGL RESOURCES (AGL) - GAS
CONTACT: MARTIN MAREK
10 PEACHTREE PLACE NE
SUITE 100
ATLANTA, GA 30309
TEL.NO.: (404) 584-4338
NOTE: ALL GAS IS OWNED BY AGL UNLESS OTHERWISE NOTED (ROF)

2. AT&T (ATT) - TELEPHONE
CONTACT: BEVERLY HALL
6602 ABERCORN STREET
SUITE 207
SAVANNAH, GA 31405
TEL.NO.: (912) 356-3945
NOTE: ALL TELEPHONE IS OWNED BY ATT UNLESS OTHERWISE NOTED (ROF)

3. CITY OF PORT WENTWORTH (COPW) - WATER & SEWER
CONTACT: RAY O'NEIL
305 SOUTH COASTAL HWY
PORT WENTWORTH, GA 31407
TEL.NO.: (912) 966-7427
NOTE: AS NOTED ON PLANS (ROF)

4. CITY OF SAVANNAH (COS) - WATER & SEWER
CONTACT: DASLIN GARCON
132 E BROUGHTON STREET
2ND FLOOR
SAVANNAH, GA 31402
TEL.NO.: (912) 651-6573
NOTE: AS NOTED ON PLANS (ROF)


5. COMCAST (CC) - CABLE TV
CONTACT: CRAIG MARKILLIE
145 PARK OF COMMERCE DRIVE
SAVANNAH, GA 31405
TEL.NO.: (912) 353-6064
NOTE: LOCATED THROUGHOUT (ROF)
6. SOUTHERN NATURAL GAS (SNG) - GAS
CONTACT: TONY GARCIA
569 BROOKWOOD VILLAGE
SUITE 501
BIRMINGHAM, AL 35209
TEL.NO.: (205) 325-3536
NOTE: AS NOTED ON PLANS (ROF)


7. GEORGIA POWER (GP) - DISTRIBUTION
CONTACT: JARRETT DAVIS
241 RALPH MCGILL BLVD
ATLANTA, GA 30396
TEL.NO.: (404) 506-4474
NOTE: LOCATED THROUGHOUT (ROF)

8. GEORGIA POWER TRANSMISSION (GPT) - TRANSMISSION
CONTACT: DON ST. CLAIR
241 RALPH MCGILL BLVD
ATLANTA, GA 30396
TEL.NO.: (404) 506-4474
NOTE: LOCATED ALONG BOURNE AVE, AUGUSTA RD, AND APPROXIMATELY 150 SOUTH OF NORFOLK SOUTHERN RAILROAD (ROF)

9. LEVEL 3 COMMUNICATIONS (L3) - TELECOMMUNICATION
CONTACT: RUSS WHEAT
3770 LUCIUS ROAD
COLUMBIA, SC 29210
TEL.NO.: (803) 239-9563
NOTE: AS NOTED ON PLANS (ROF)

10. HARGRAY COMMUNICATIONS (HC) - TELECOMMUNICATION
CONTACT: DEAN PITTINGER
5 STATE ROAD S-7-29
BLUFFTON, SC 29910
TEL.NO.: (877) 420-7729
NOTE: LOCATED ALONG CROSSGATE DRIVE (RNA)
11. NORFOLK SOUTHERN RAILROAD (NSRR) - TRACKS
CONTACT: JAMES SPILLIARDS
3 NORTH MAIN STREET
GARDEN CITY, GA 31408
TEL.NO.: (912) 963-6925
NOTE: NO UTILITIES FOUND, ONLY TRACKS (RNA)

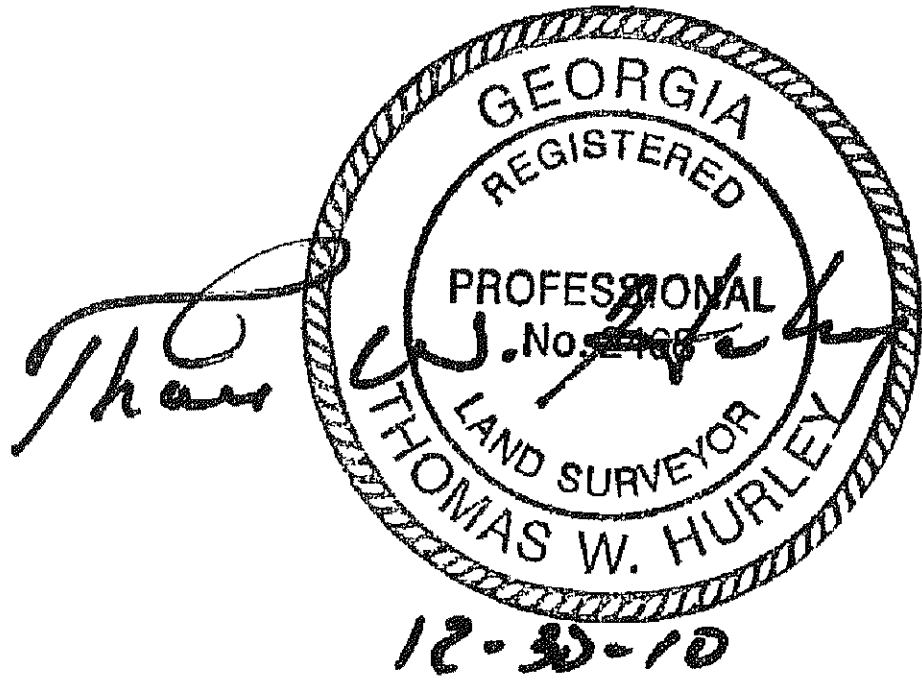

PLAN RELEASE				TBE PROJECT NUMBER		 PEACHTREE CORPORATE CENTER 6649 PEACHTREE INDUSTRIAL BLVD. SUITE J, NORCROSS GA 30092-4302 TELEPHONE: 678.421.0080 FAX: 678.421.0080	NOT TO SCALE	REVISION DATES		STATE OF GEORGIA DEPARTMENT OF TRANSPORTATION	
DRAWN BY	DATE	CHECKED BY	DATE	GA-095-007-04						OFFICE: UTILITIES, JUN BIRNKAMMER, EIT	
BGC	10/04/10	BC	12/07/10							UTILITY PLANS	
BGC	12/07/10	TWH	12/08/10	TBE CONTACT						JIMMY DELOACH CONNECTOR	
BGC	12/09/10	RC	12/09/10	THOMAS W. HURLEY, R. L. S.							
BGC	12/13/10	RWS	12/12/10							DRAWING No. 24-0B	
										P. I. NO. 0008690	